



AS-BUILT PLANS 12/12/12

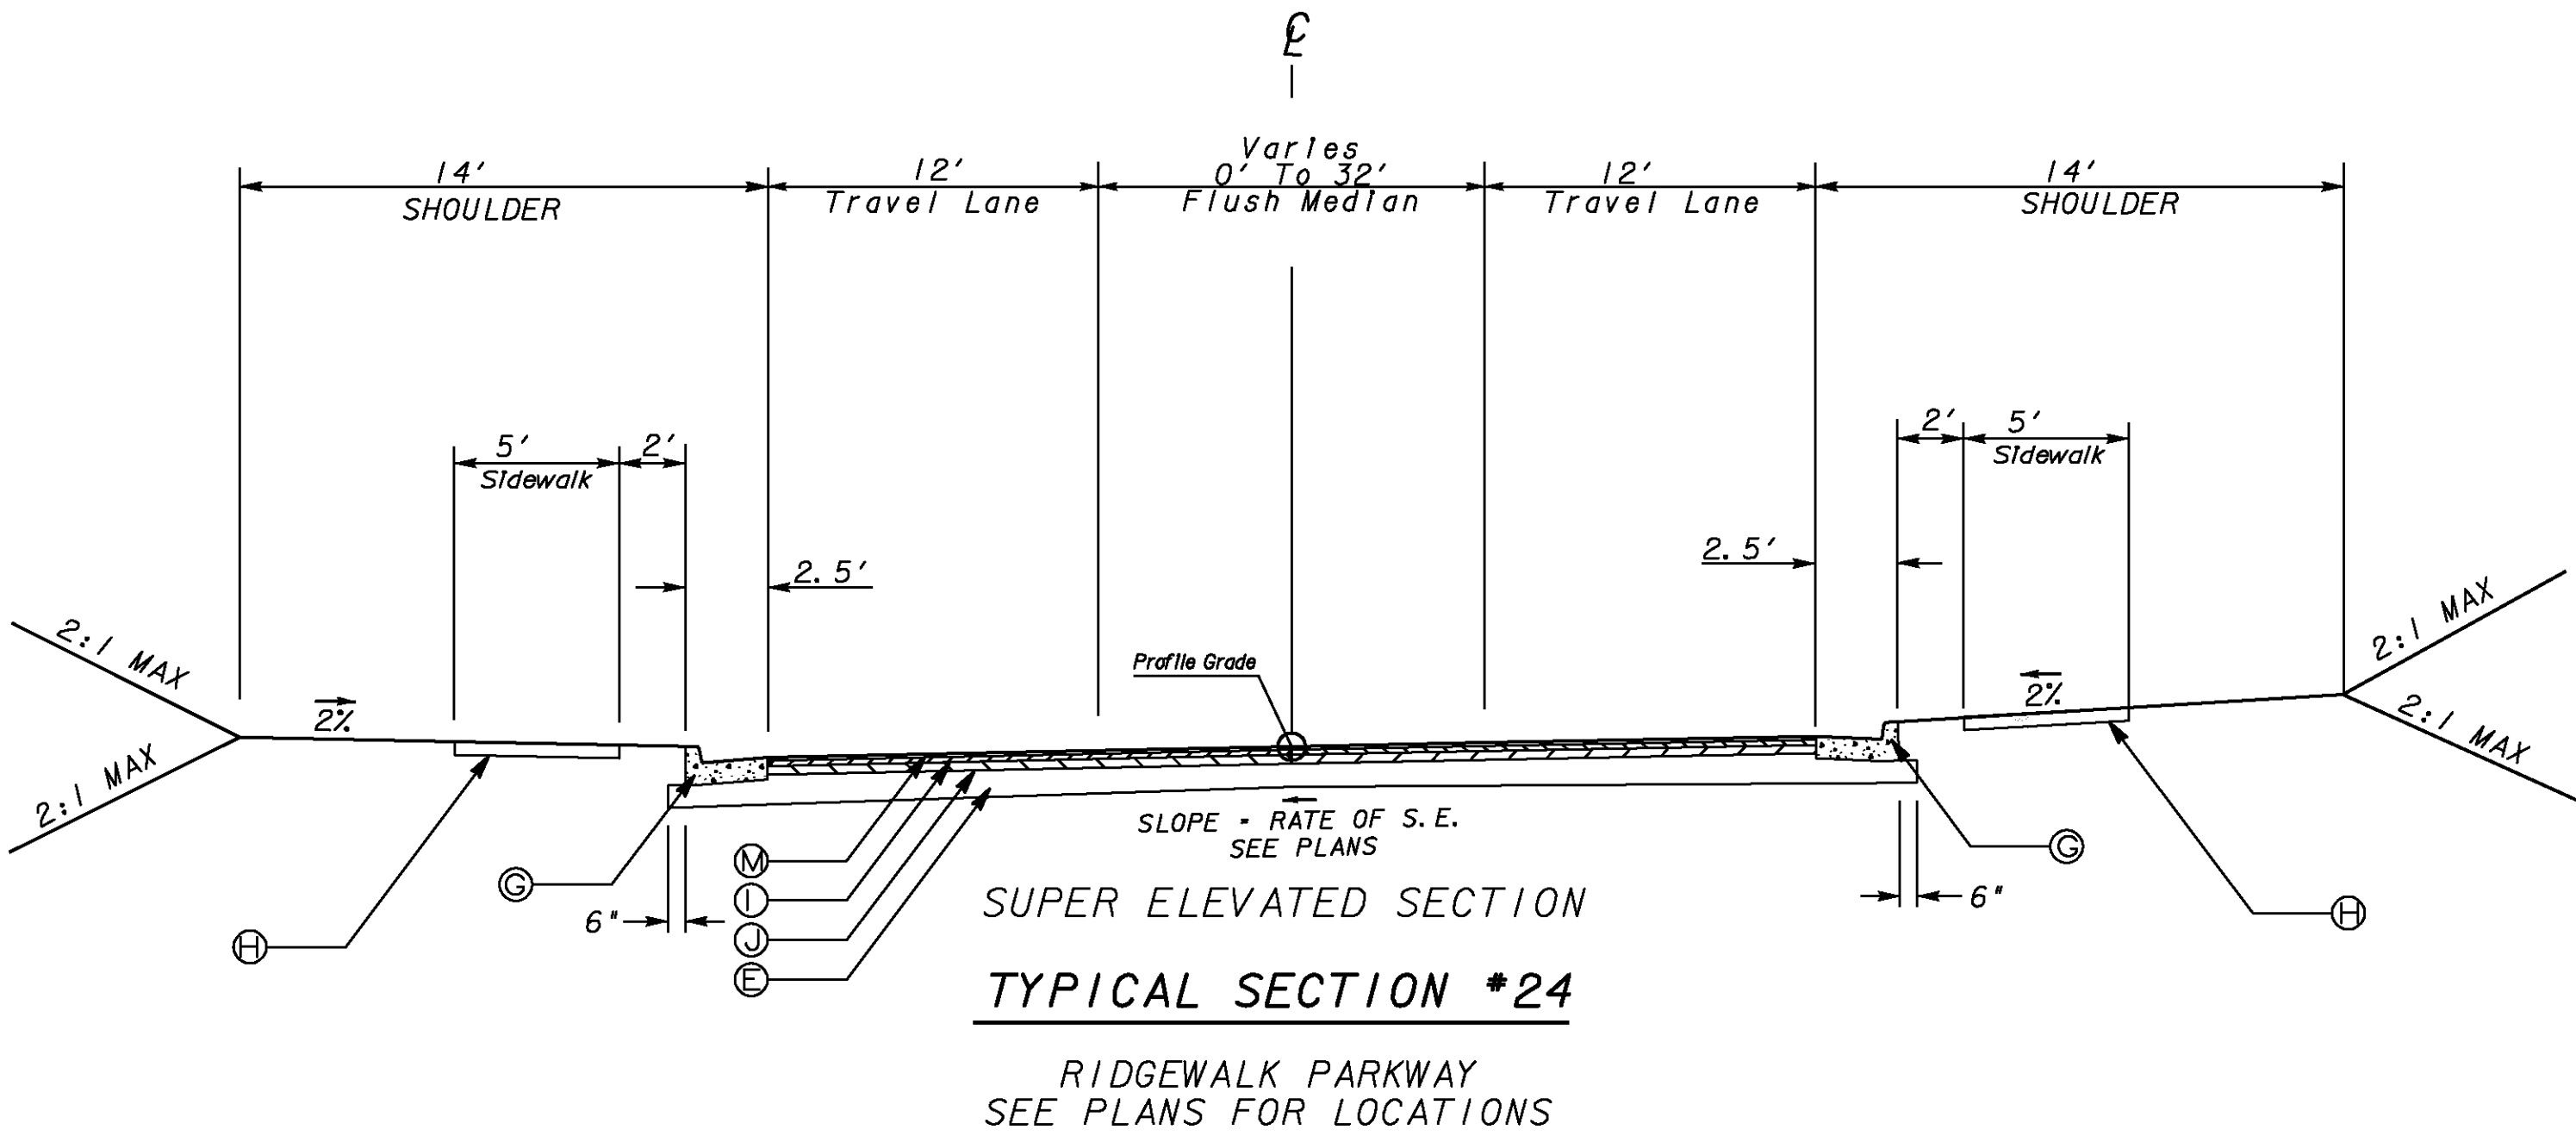

- REQUIRED PAVEMENT**
- (A) ASPHALTIC CONC. 12.5 mm OGFC, GROUP 2, INCL POLYMER-MODIFIED, 90*/SY
 - (B) ASPHALTIC CONCRETE 12.5 mm SMA, 165*/SY
 - (C) ASPHALTIC CONCRETE 19 mm SUPERPAVE, 330*/SY
 - (D) ASPHALTIC CONCRETE 25 mm SUPERPAVE, 880*/SY
 - (E) GRADED AGGREGATE BASE, 12"
 - (F) PLAIN PORTLAND CEMENT CONCRETE, 9"
 - (G) 8"x30" CONC. CURB & GUTTER, GA. STD. 9032 B. TYPE 2
 - (H) 4"x5' CONC. SIDEWALK, DETAIL A-3
 - (I) ASPHALTIC CONCRETE 19mm SUPERPAVE, 220 lb/yd
 - (J) ASPHALTIC CONCRETE 25mm SUPERPAVE, 440 lb/yd
 - (K) GRADED AGGREGATE BASE, 10"
 - (L) CONC MEDIAN PAVING, TYPE 7 CURB FACE, 6 IN
 - (M) ASPHALTIC CONCRETE 12.5 mm SUPERPAVE, 165*/SY
 - (N) ASPHALTIC CONCRETE 25mm SUPERPAVE, 330 lb/yd
 - (O) ASPHALTIC CONCRETE MILLING OR LEVELING AS REQD
 - (P) GRADED AGGREGATE BASE, 8"
 - (Q) CONTINUOUS INDENTATION RUMBLE STRIPS - GROUND-IN-PLACE INTERSTATE

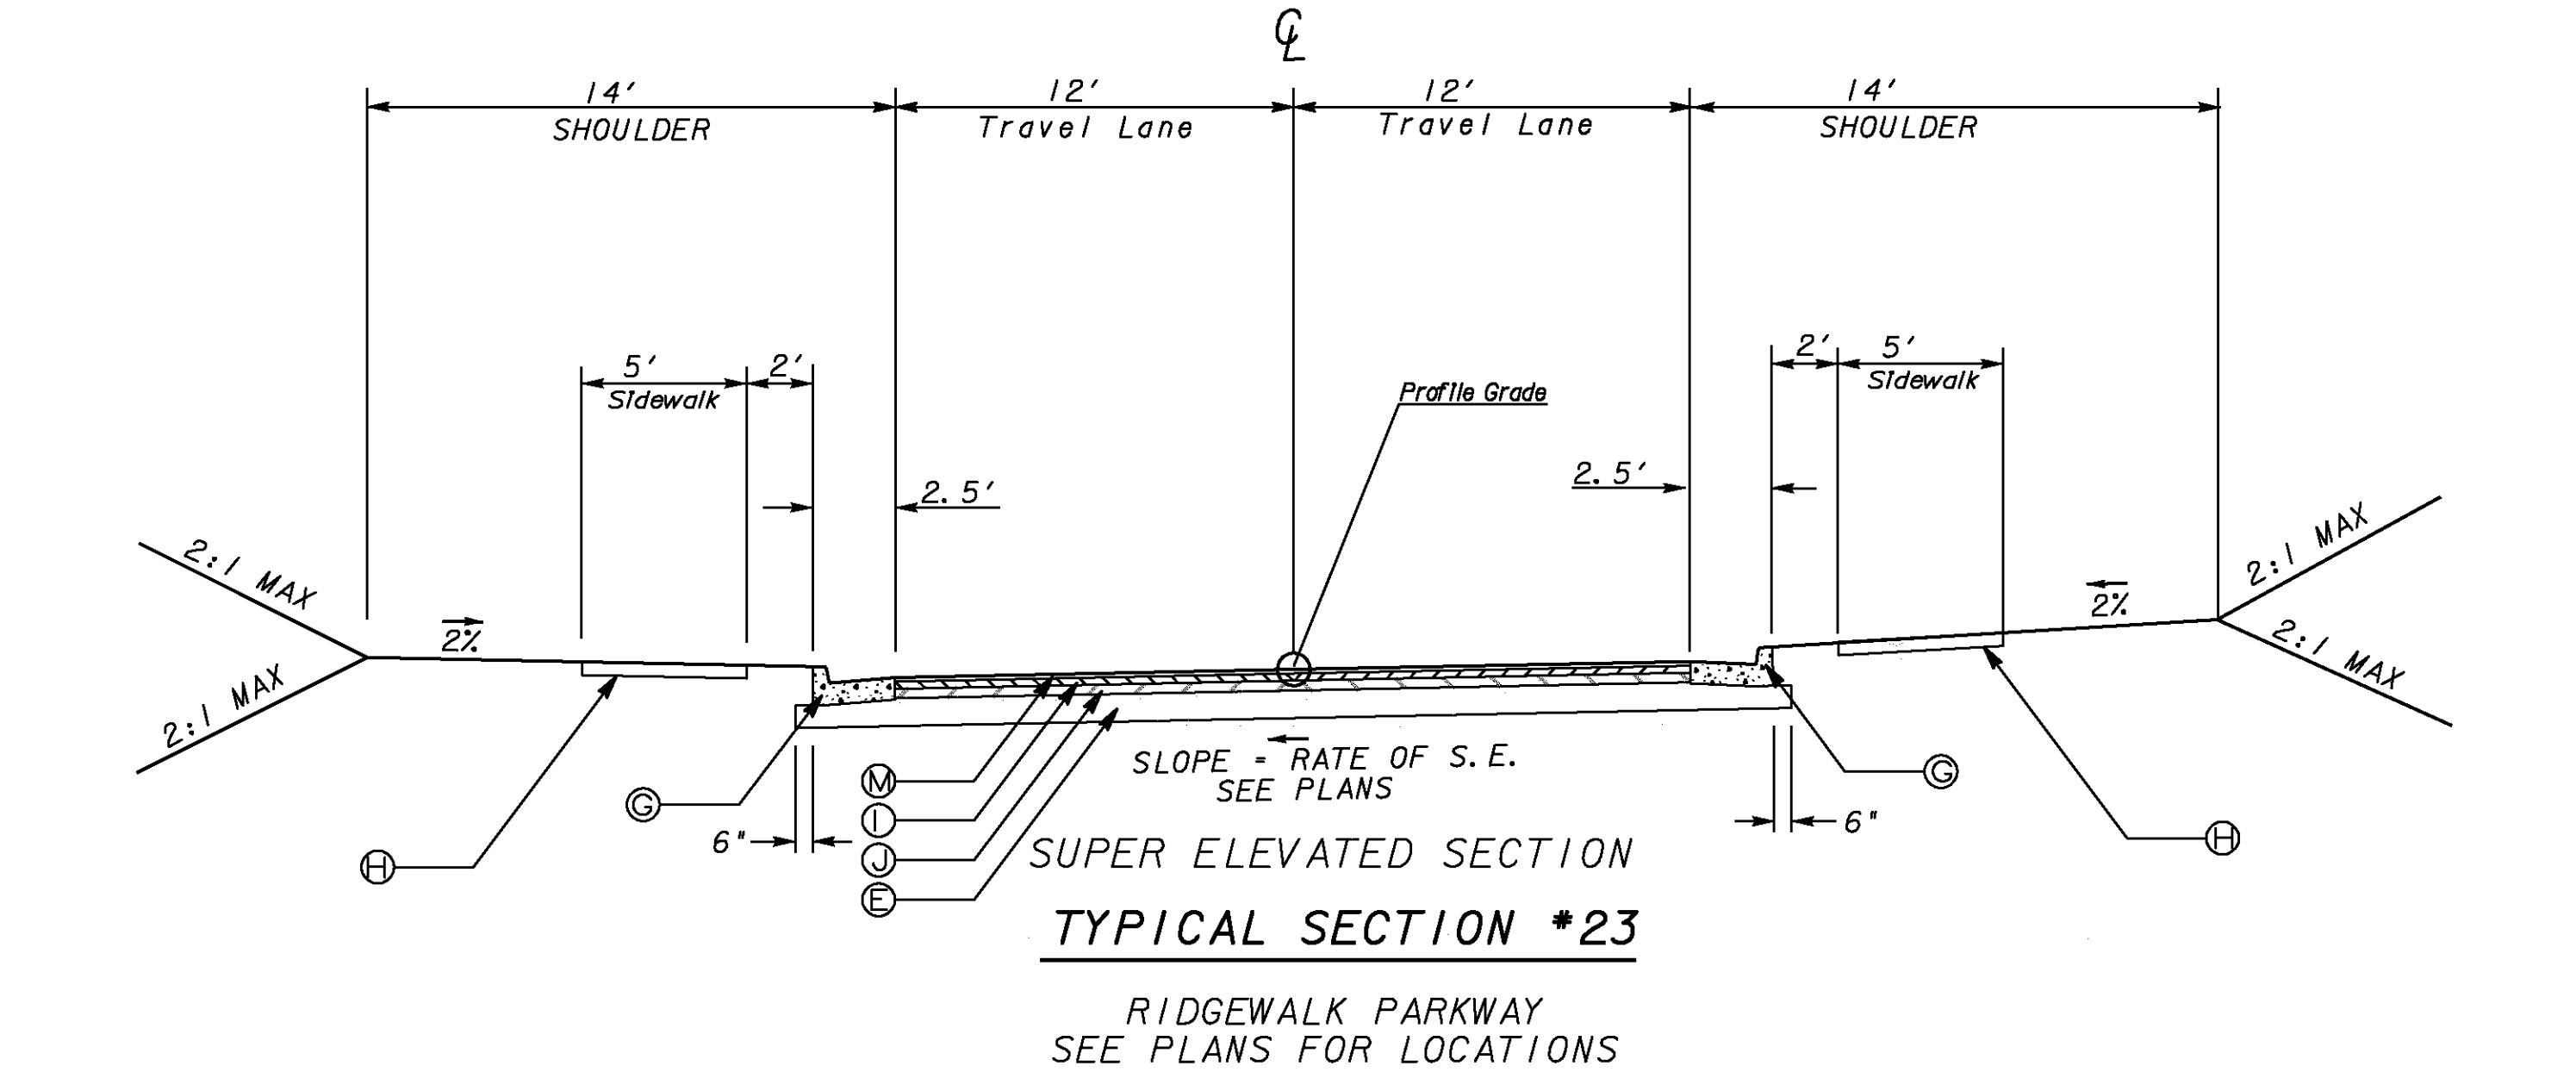